



SHEET 2



REGISTERED SURVEYOR'S CERTIFICATION

Saunders Havill Group Pty Ltd, Registered Surveyor, hereby certifies that the vertical and horizontal locations and dimensions shown on this plan are a true and correct record and were located by survey.

Authorized Signatory:  Reg Surveyor No 4611 Date 19/06/20

OW/24/2019


AS CONSTRUCTED REFERENCE SET ONLY

REFER TO SURVEYORS AS CONSTRUCTED PLANS FOR FINAL LEVELS AND CONSTRUCTED INFORMATION

ENGINEER'S CERTIFICATION

I, **PETER INGERMAN**, being a Consulting Engineer and duly authorized representative of: **EMPOWER ENGINEERS AND PROJECT MANAGERS** hereby:-

- certify the information contained in this drawing is an accurate "as constructed" representation of the works;
- accept responsibility for the "as constructed" information contained in this drawing; and
- acknowledge the "as constructed" information contained in the drawing may be relied on by the LOGAN CITY COUNCIL and others.

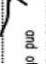Certification for Stage 1 by  on 19/06/20

For: **EMPPOWER ENGINEERS AND PROJECT MANAGERS** PPO.94424

saunders havill group

Saunders Havill Group Pty Ltd ABN 24 144 972 949
 Brisbane @ Springfield @ Rockhampton
 Head office: 9 Thompson St Bowen Hills Q 4006
 phone 800 23 SHG web www.saundershavill.com

surveying # town planning # urban design # environmental management # landscape architecture

No.	Drawn	Date	Description	Checked
A	JTC	10.06.2020	Original Issue	SB
B	JTC	12.06.2020	Minor Amendments	SB
C	JTC	19.06.2020	Minor Amendments	SB

AS CONSTRUCTED

SEWER RETICULATION - KEY MAP

THE BANKS - STAGE 1

Client: **URBEX PTY LTD**

Scale 1:600 - Lengths are in Metres.

Scale @A1 1:600
 @A3 1:1200

Sheet 1 of 4
 Dwg No. **8131 S 34 C AC**



SCHOOL

JACKSON CHASE

1000

800


JACKSON

901

JACKSON

ROAD

902

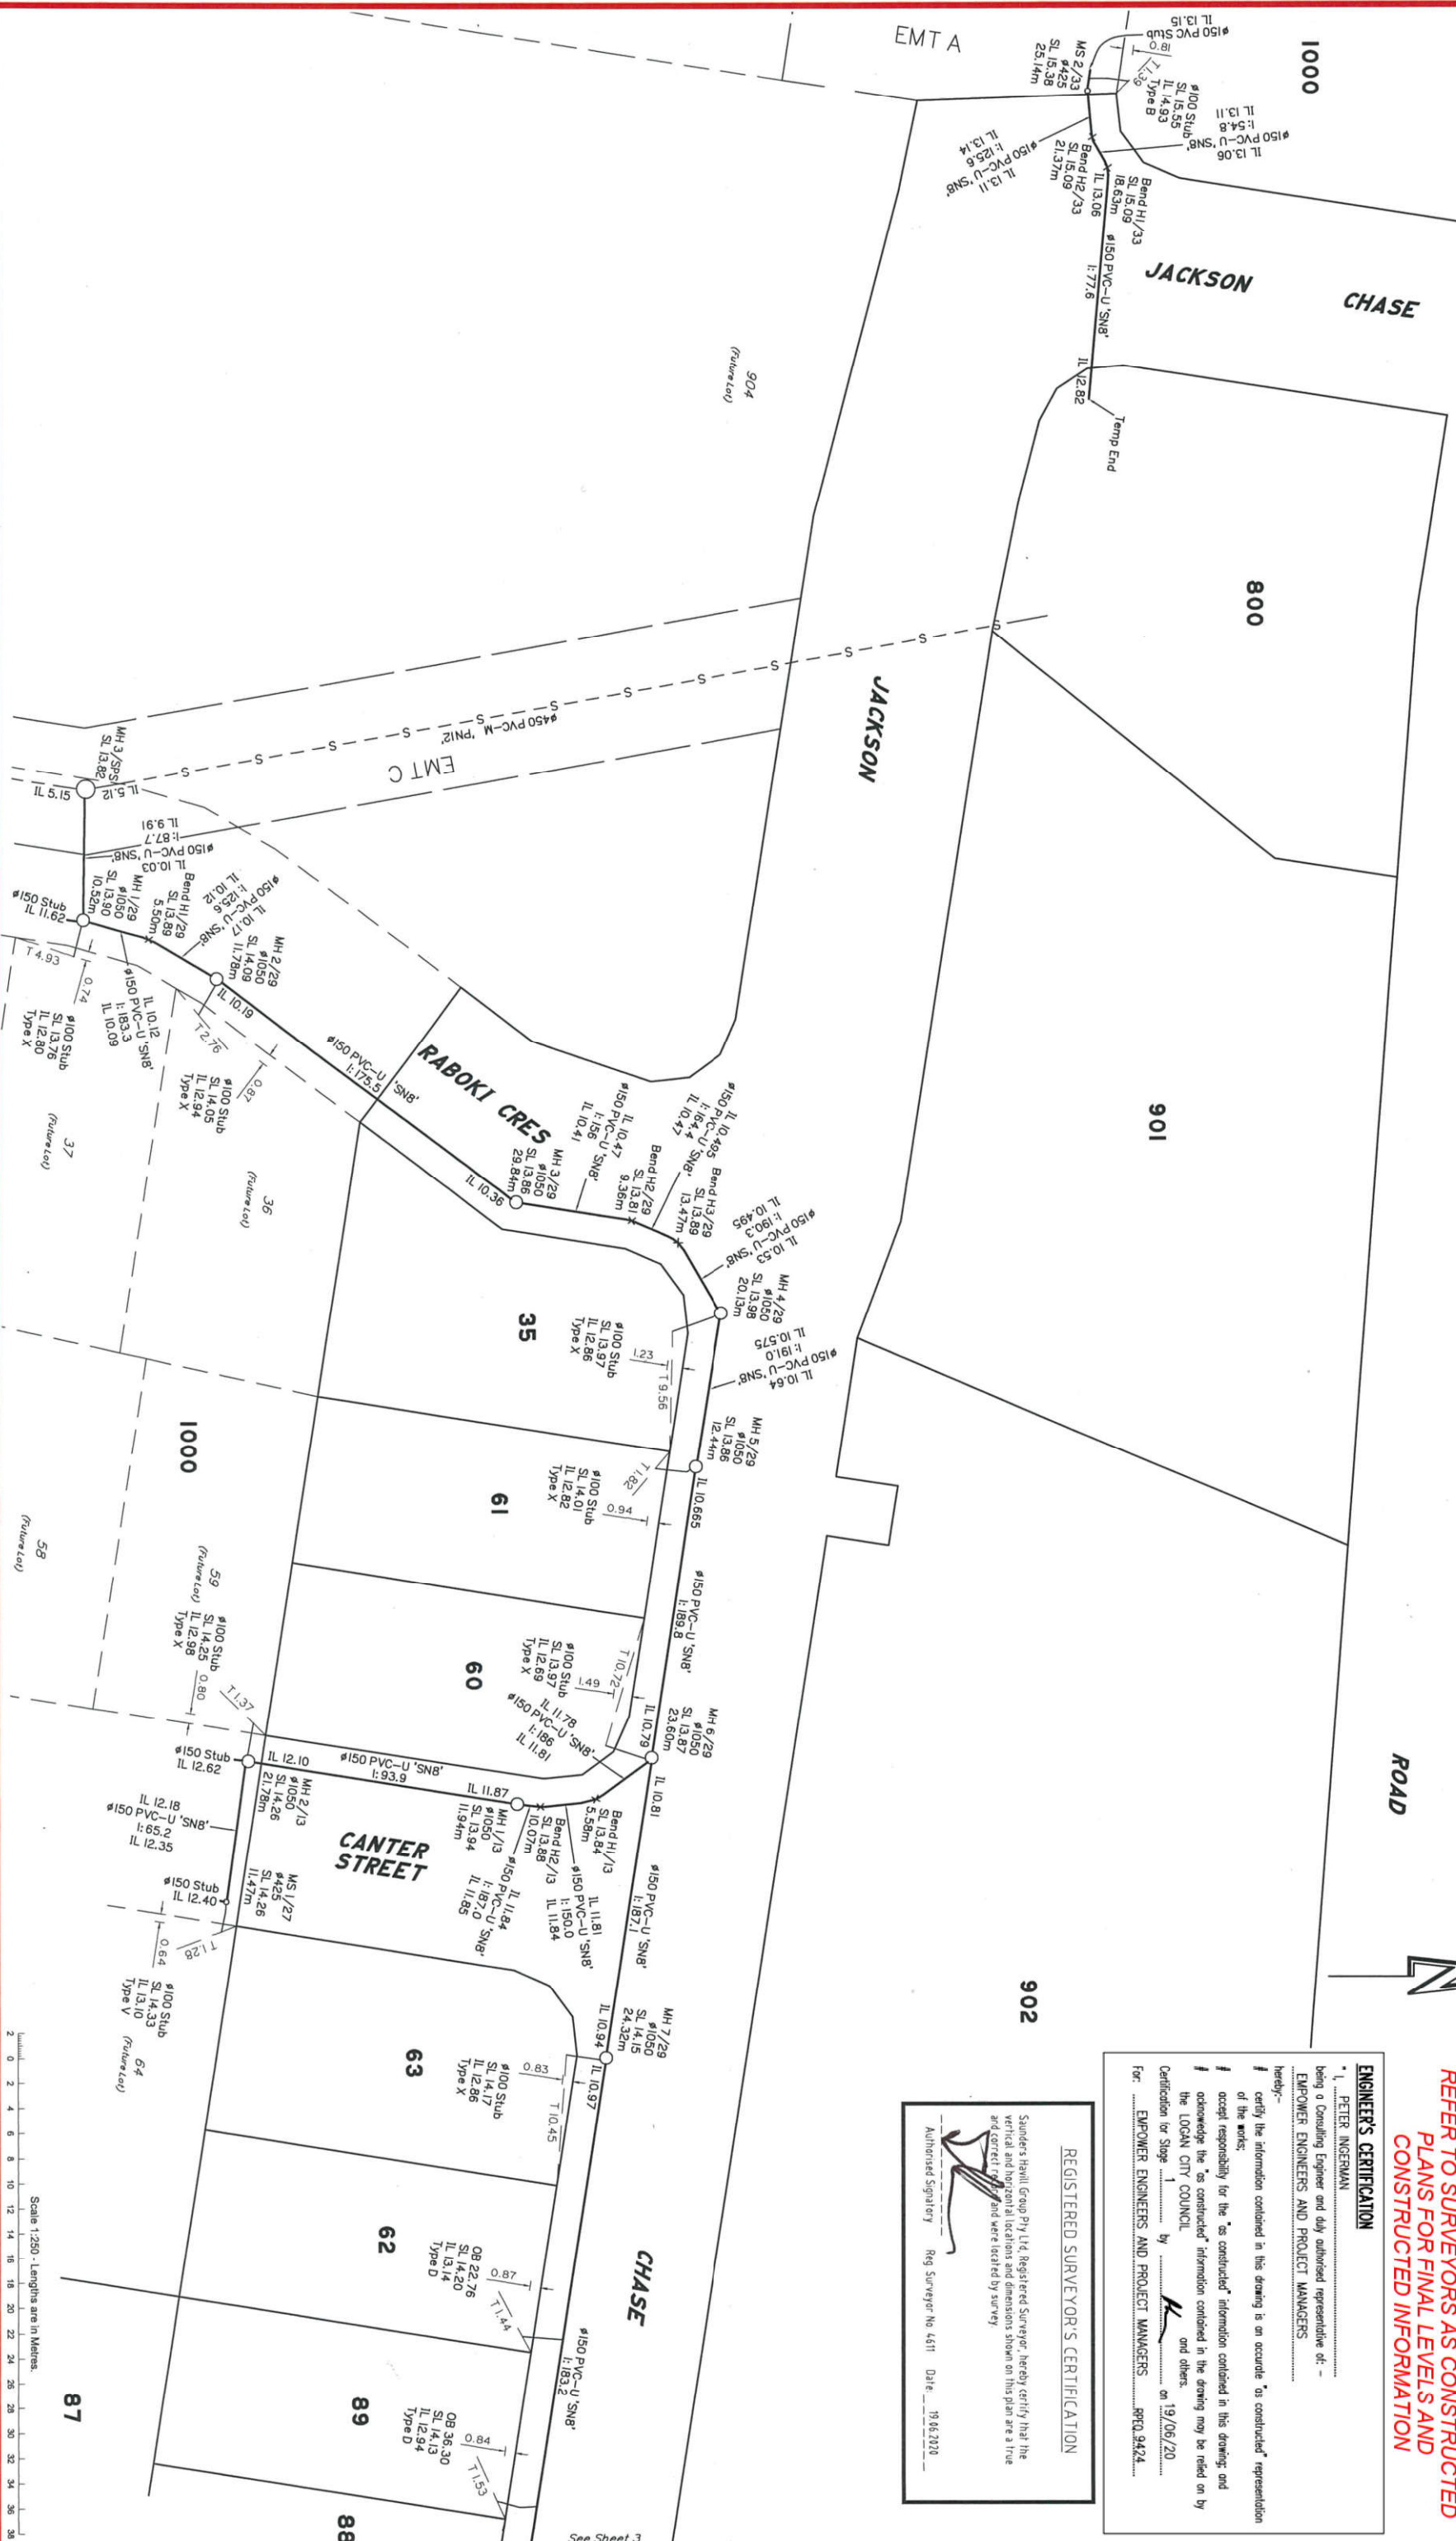

AS CONSTRUCTED REFERENCE SET ONLY
REFER TO SURVEYORS AS CONSTRUCTED PLANS FOR FINAL LEVELS AND CONSTRUCTED INFORMATION

ENGINEER'S CERTIFICATION

I, **PETER INGERMAN**, being a Consulting Engineer and duly authorized representative of - **EMPOWER ENGINEERS AND PROJECT MANAGERS** hereby certify that the information contained in this drawing is an accurate representation of the works; I accept responsibility for the "as constructed" information contained in this drawing; and I acknowledge the "as constructed" information contained in the drawing may be relied on by the **LOGAN CITY COUNCIL** and others. Certification for Stage 1 by **EMPOWER ENGINEERS AND PROJECT MANAGERS** on 19/06/20 For: **EMPOWER ENGINEERS AND PROJECT MANAGERS** ppc 9474

REGISTERED SURVEYOR'S CERTIFICATION

Saunders Havill Group Pty Ltd, Registered Surveyor, hereby certifies that the vertical and horizontal locations and dimensions shown on this plan are a true and correct statement of the facts as shown on the survey.
 Authenticated Signatory: Reg. Surveyor No 4611 Date: 19/06/2020

saunders havill group
 Saunders Havill Group Pty Ltd ABN 24 144 972 949
 Brisbane • Springfield • Rockhampton
 Head office: 9 Thompson St Bowen Hills Q 4006
 phone 1800 23 SHG web www.saundershavill.com
 #surveying #townplanning #urbandesign #environmentalmanagement #landscapearchitecture

No.	Drawn	Date	Description	Checked
A	JTC	10.06.2020	Original Issue	SB
B	JTC	12.06.2020	Minor Amendments	SB
C	JTC	19.06.2020	Minor Amendments	SB

AS CONSTRUCTED SEWER RETICULATION
THE BANKS - STAGE 1
 URBEX PTY LTD

Scale 1:250 - Lengths are in Metres.
 Surveyed: NC Date: MAY 2020
 Level Datum: AHD der.
 Origin of Levels: PM130385
 RL of Origin: RL 15.546
 Contour Interval:
 Lot Description: Plan of Lots 35, 60-63, 84-128, 194-197, 800, 901, 902, 905, 1000 & 9000 on SP313771
 Locality: Logan Reserve
 Local Government: Logan City
 Dwg No. 8131 S 34 C AC

No.	Drawn	Date	Description	Checked
A	JTC	10.06.2020	Original Issue	SB
B	JTC	12.06.2020	Minor Amendments	SB
C	JTC	19.06.2020	Minor Amendments	SB

Client: URBEX PTY LTD
 Project: THE BANKS - STAGE 1
 SEWER RETICULATION
 Plan of: AS CONSTRUCTED

Level Datum: AHD der.
 Origin of Levels: PM130385
 RL of Origin: RL15.546
 Contour Interval: _____

Lot Description: _____
 Surveyed Date: MAY 2020
 NC
 Dwg No. 8131 S 34 C AC
 Scale @A1 1:250
 Scale @A3 1:500
 Sheet 3 of 4

ENGINEER'S CERTIFICATION
 I, PETER INGERMAN
 being a Consulting Engineer and duly authorized representative of:-
 EMPOWER ENGINEERS AND PROJECT MANAGERS
 certify the information contained in this drawing is an accurate 'as constructed' representation
 of the works.
 I accept responsibility for the 'as constructed' information contained in this drawing, and
 acknowledge the 'as constructed' information contained in the drawing may be relied on by
 the LOGAN CITY COUNCIL
 on 19/06/20
 Certification for Stage 1 by _____
 For: EMPOWER ENGINEERS AND PROJECT MANAGERS
 PPO 9424


REGISTERED SURVEYOR'S CERTIFICATION
 Saunders Havill Group Pty Ltd, Registered Surveyor, hereby certifies that the
 vertical and horizontal locations and dimensions shown on this plan are a true
 and correct representation of the locations and dimensions of the works
 and correct for any and all errors and were located by survey.
 Reg. Surveyor No. 6111 Date: 19.06.2020

SAUNDERS HAVILL GROUP
 Saunders Havill Group Pty Ltd ABN 24 144 972 949
 Brisbane • Springfield • Rockhampton
 head office 9 Thompson St Bowen Hills Q 4006
 phone 800 023 5HG web www.saundershavill.com

• surveying • town planning • urban design • environmental management • landscape architecture

**AS CONSTRUCTED REFERENCE
 SET ONLY
 PLANS FOR FINAL LEVELS AND
 CONSTRUCTED INFORMATION
 REFER TO SURVEYORS AS CONSTRUCTED**

OW/24/2019

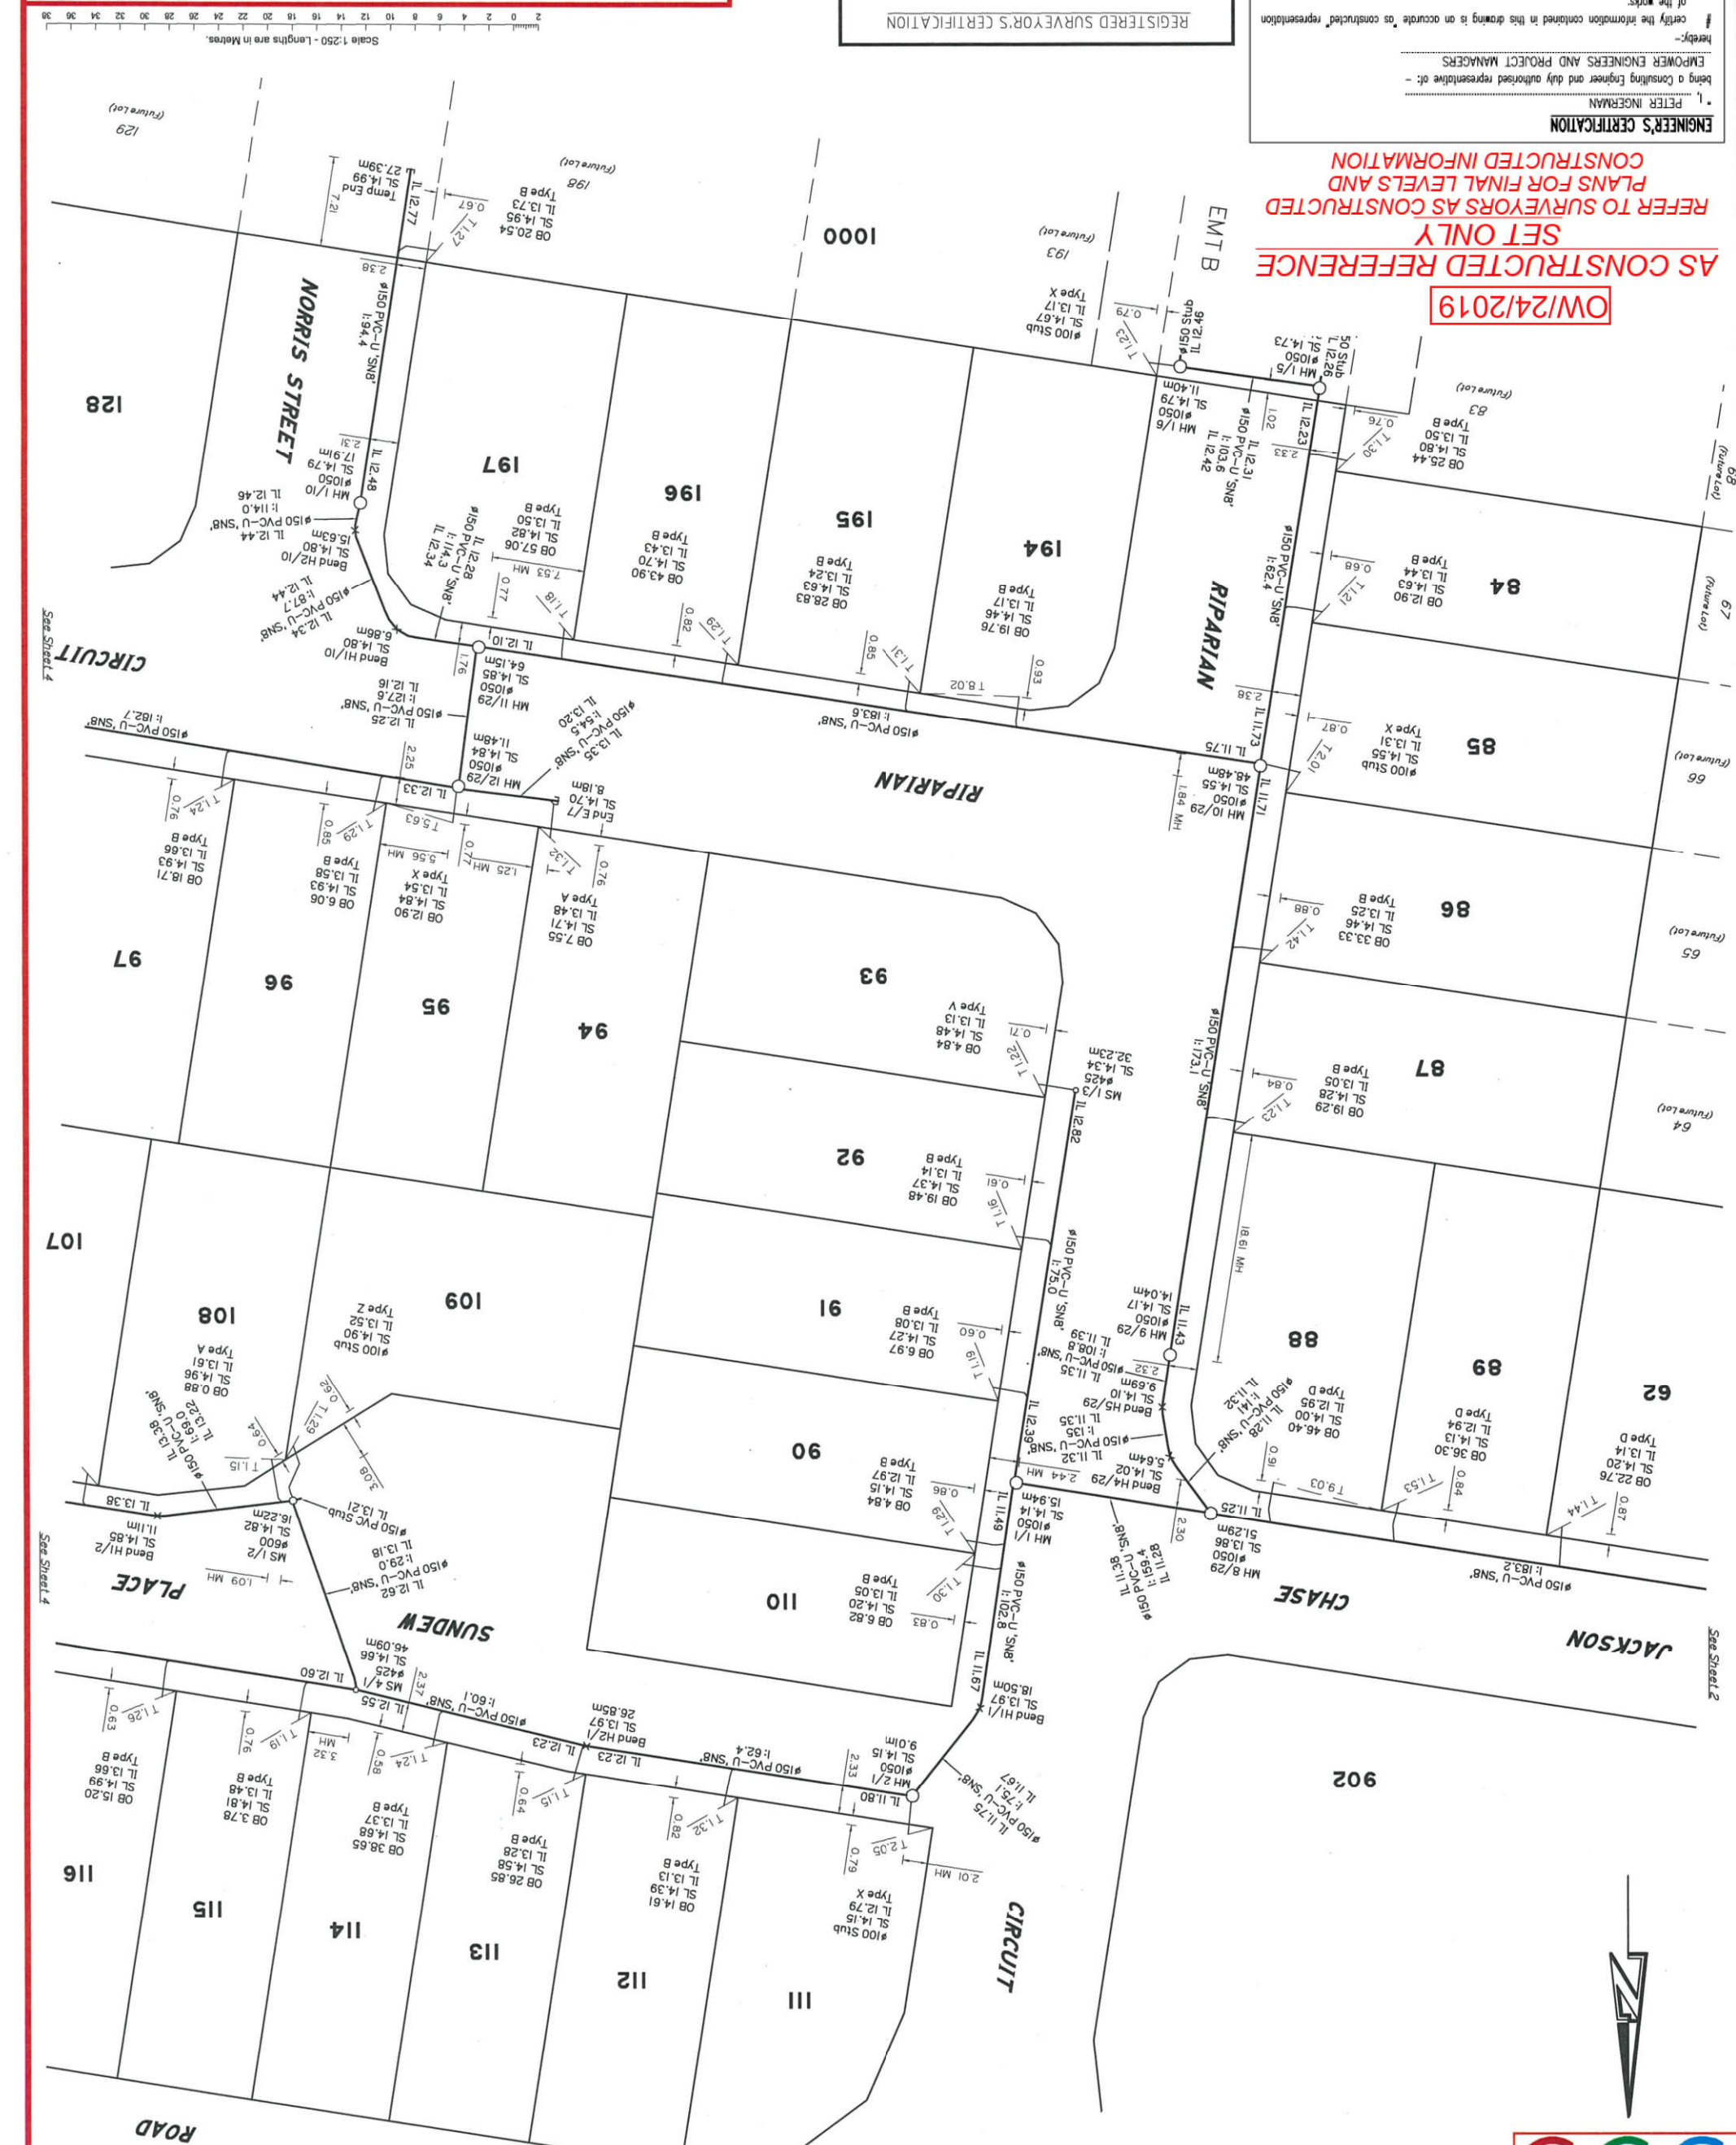

No.	Drawn	Date	Description	Checked
A	JTC	10.06.2020	Original Issue	SB
B	JTC	12.06.2020	Minor Amendments	SB
C	JTC	19.06.2020	Minor Amendments	SB

Client: URBEX PTY LTD
 Project: THE BANKS - STAGE 1
 AS CONSTRUCTED
 SEWER RETICULATION

Level Datum: AHD der.
 Origin of Levels: PM130385
 RL of Origin: RL15.546
 Contour Interval:

Plan of Lots 35, 60-63, 84-128,
 194-197, 800, 901, 902, 905,
 1000 & 9000 on SP313771
 Local Government:
 Logan City
 Dwg No. 8131 S 34 C AC
 Scale @A1 1:250
 @A3 1:500
 Surveying
 Sheet 4 of 4

ENGINEER'S CERTIFICATION
 I, PETER INGERMAN
 being a Consulting Engineer and duly authorised representative of:
 EMPOWER ENGINEERS AND PROJECT MANAGERS
 certify the information contained in this drawing is an accurate "as constructed" representation
 of the works;
 I accept responsibility for the "as constructed" information contained in this drawing, and
 acknowledge the "as constructed" information contained in the drawing may be relied on by
 the LOGAN CITY COUNCIL
 and others.
 Certification for Stage 1 By on 19/06/20
 For: EMPOWER ENGINEERS AND PROJECT MANAGERS
 REG. 9424

REGISTERED SURVEYOR'S CERTIFICATION
 Saunders Havill Group Pty Ltd, Registered Surveyor, hereby certifies that the
 vertical and horizontal locations and dimensions shown on this plan are a true
 and correct record and were located by survey.
 Authorised Signatory: [Signature]
 Reg. Surveyor No. 4611 Date: 19.06.2020

**AS CONSTRUCTED REFERENCE
 SET ONLY
 REFER TO SURVEYORS AS CONSTRUCTED
 PLANS FOR FINAL LEVELS AND
 CONSTRUCTED INFORMATION**

OW/24/2019



SAUNDERS HAVILL GROUP
 Saunders Havill Group Pty Ltd ABN 24 144 972 949
 Brisbane • Springfield • Rockhampton
 head office 9 Thompson St Bowen Hills Q 4006
 phone 800 123 5HG web www.saundershavill.com
 • surveying • town planning • urban design • environmental management • landscape architecture

