




SHEET 2

SHEET 3

SHEET 4

SHEET 5

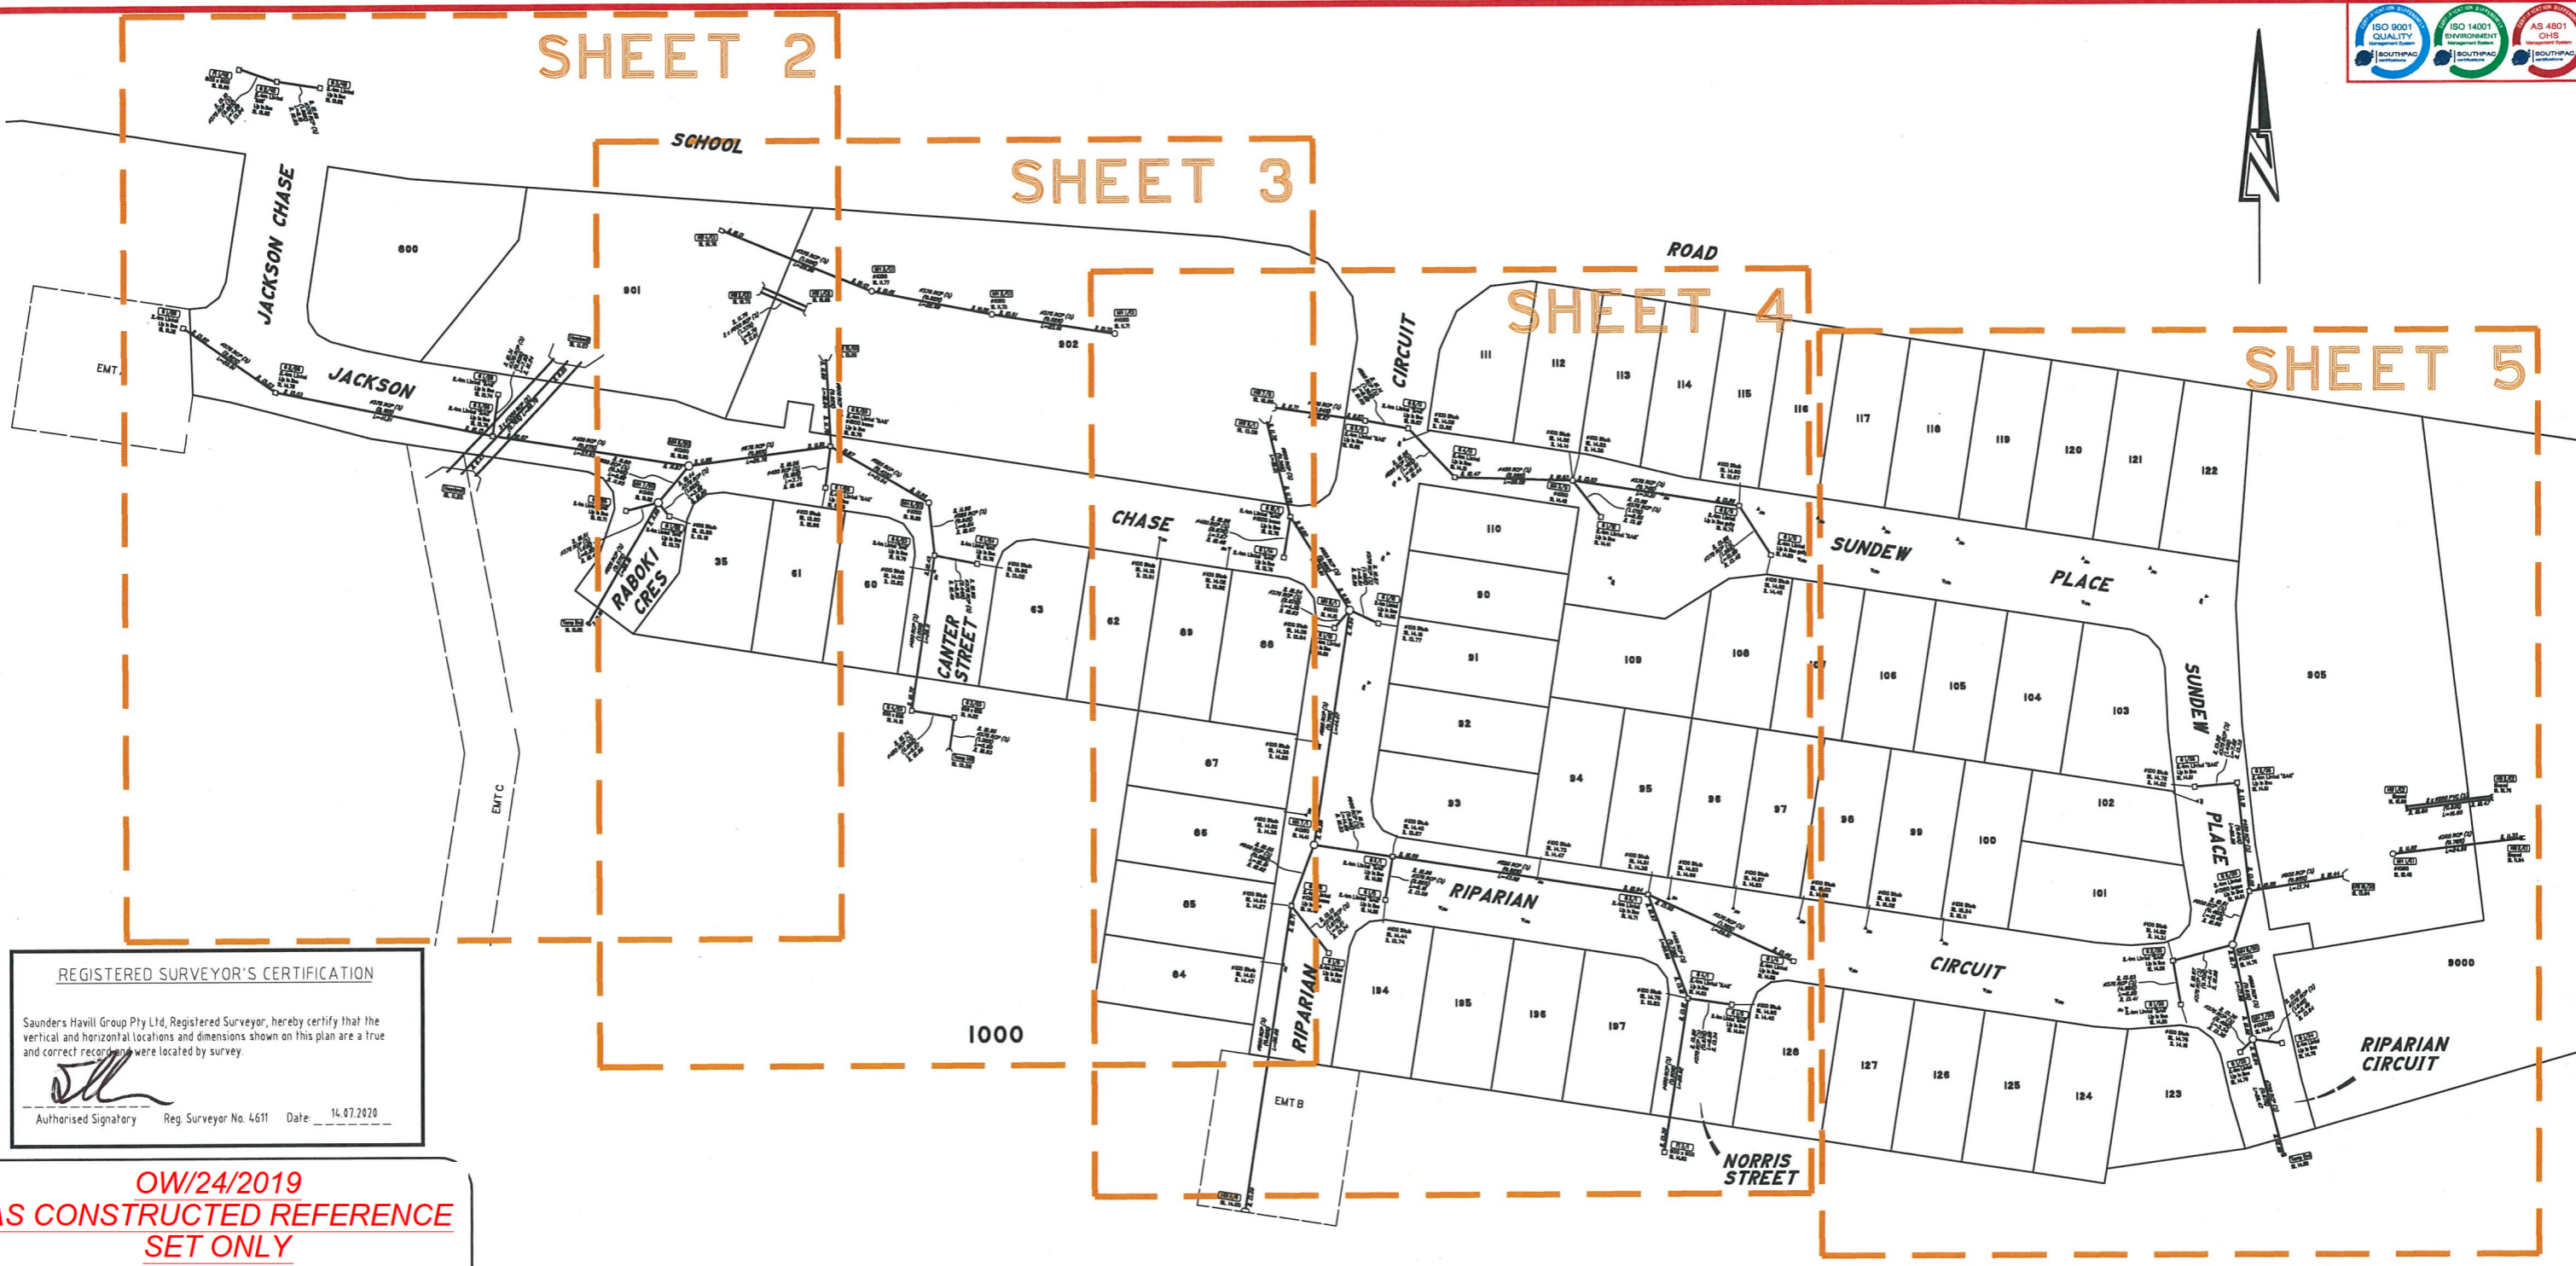

REGISTERED SURVEYOR'S CERTIFICATION

Saunders Havill Group Pty Ltd, Registered Surveyor, hereby certify that the vertical and horizontal locations and dimensions shown on this plan are a true and correct record as were located by survey.

[Signature]
 Authorised Signatory Reg. Surveyor No. 4611 Date: 14.07.2020

**OW/24/2019
 AS CONSTRUCTED REFERENCE
 SET ONLY**


REFER TO SURVEYORS AS CONSTRUCTED
 PLANS FOR FINAL LEVELS AND
 CONSTRUCTED INFORMATION

ENGINEER'S CERTIFICATION - LCC REF. OW/24/2019

I, PETER INGERMAN
 being a Consulting Engineer and duly authorised representative of:-
 EMPOWER ENGINEERS AND PROJECT MANAGERS
 hereby:-

- certify the information contained in this drawing is generally in accordance with the approved design and is an accurate "as constructed" representation of the works;
- accept responsibility for the "as constructed" information contained in this drawing; and
- acknowledge the "as constructed" information contained in the drawing may be relied on by the LOGAN CITY COUNCIL and others.

Certification for Stage 1 by *[Signature]* on 22/07/20
 For: EMPOWER ENGINEERS AND PROJECT MANAGERS RPEQ.9424

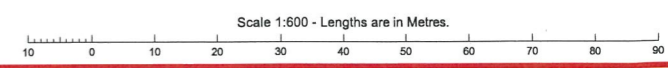

SH saunders havill group
 Saunders Havill Group Pty Ltd ABN 24 144 972 949
 Brisbane • Springfield • Rockhampton
 head office 9 Thompson St Bowen Hills Q 4006
 phone 1300 123 SHG web www.saundershavill.com

• surveying • town planning • urban design • environmental management • landscape architecture

No.	Drawn	Date	Description	Checked
A	JTC	14.07.2020	Original Issue	SB

**AS CONSTRUCTED
 STORMWATER DRAINAGE - KEY MAP**

Plan of

Project **THE BANKS - STAGE 1**

Client **URBEX PTY LTD**

Surveyed BH/MB Date MAY 2020

Level Datum: AHD der.

Origin of Levels: PM130385
 RL of Origin: RL15.546


Contour Interval:

Lot Description
 Plan of Lots 35, 60-63, 84-128,
 194-197, 800, 901, 902, 905,
 1000 & 9000 on SP313771
 Locality: Logan Reserve
 Local Government:
 Logan City

surveying Sheet 1 of 5

Scale @A1 1: 600
 @A3 1: 1200


Dwg No. **8131 S 36 A AC**

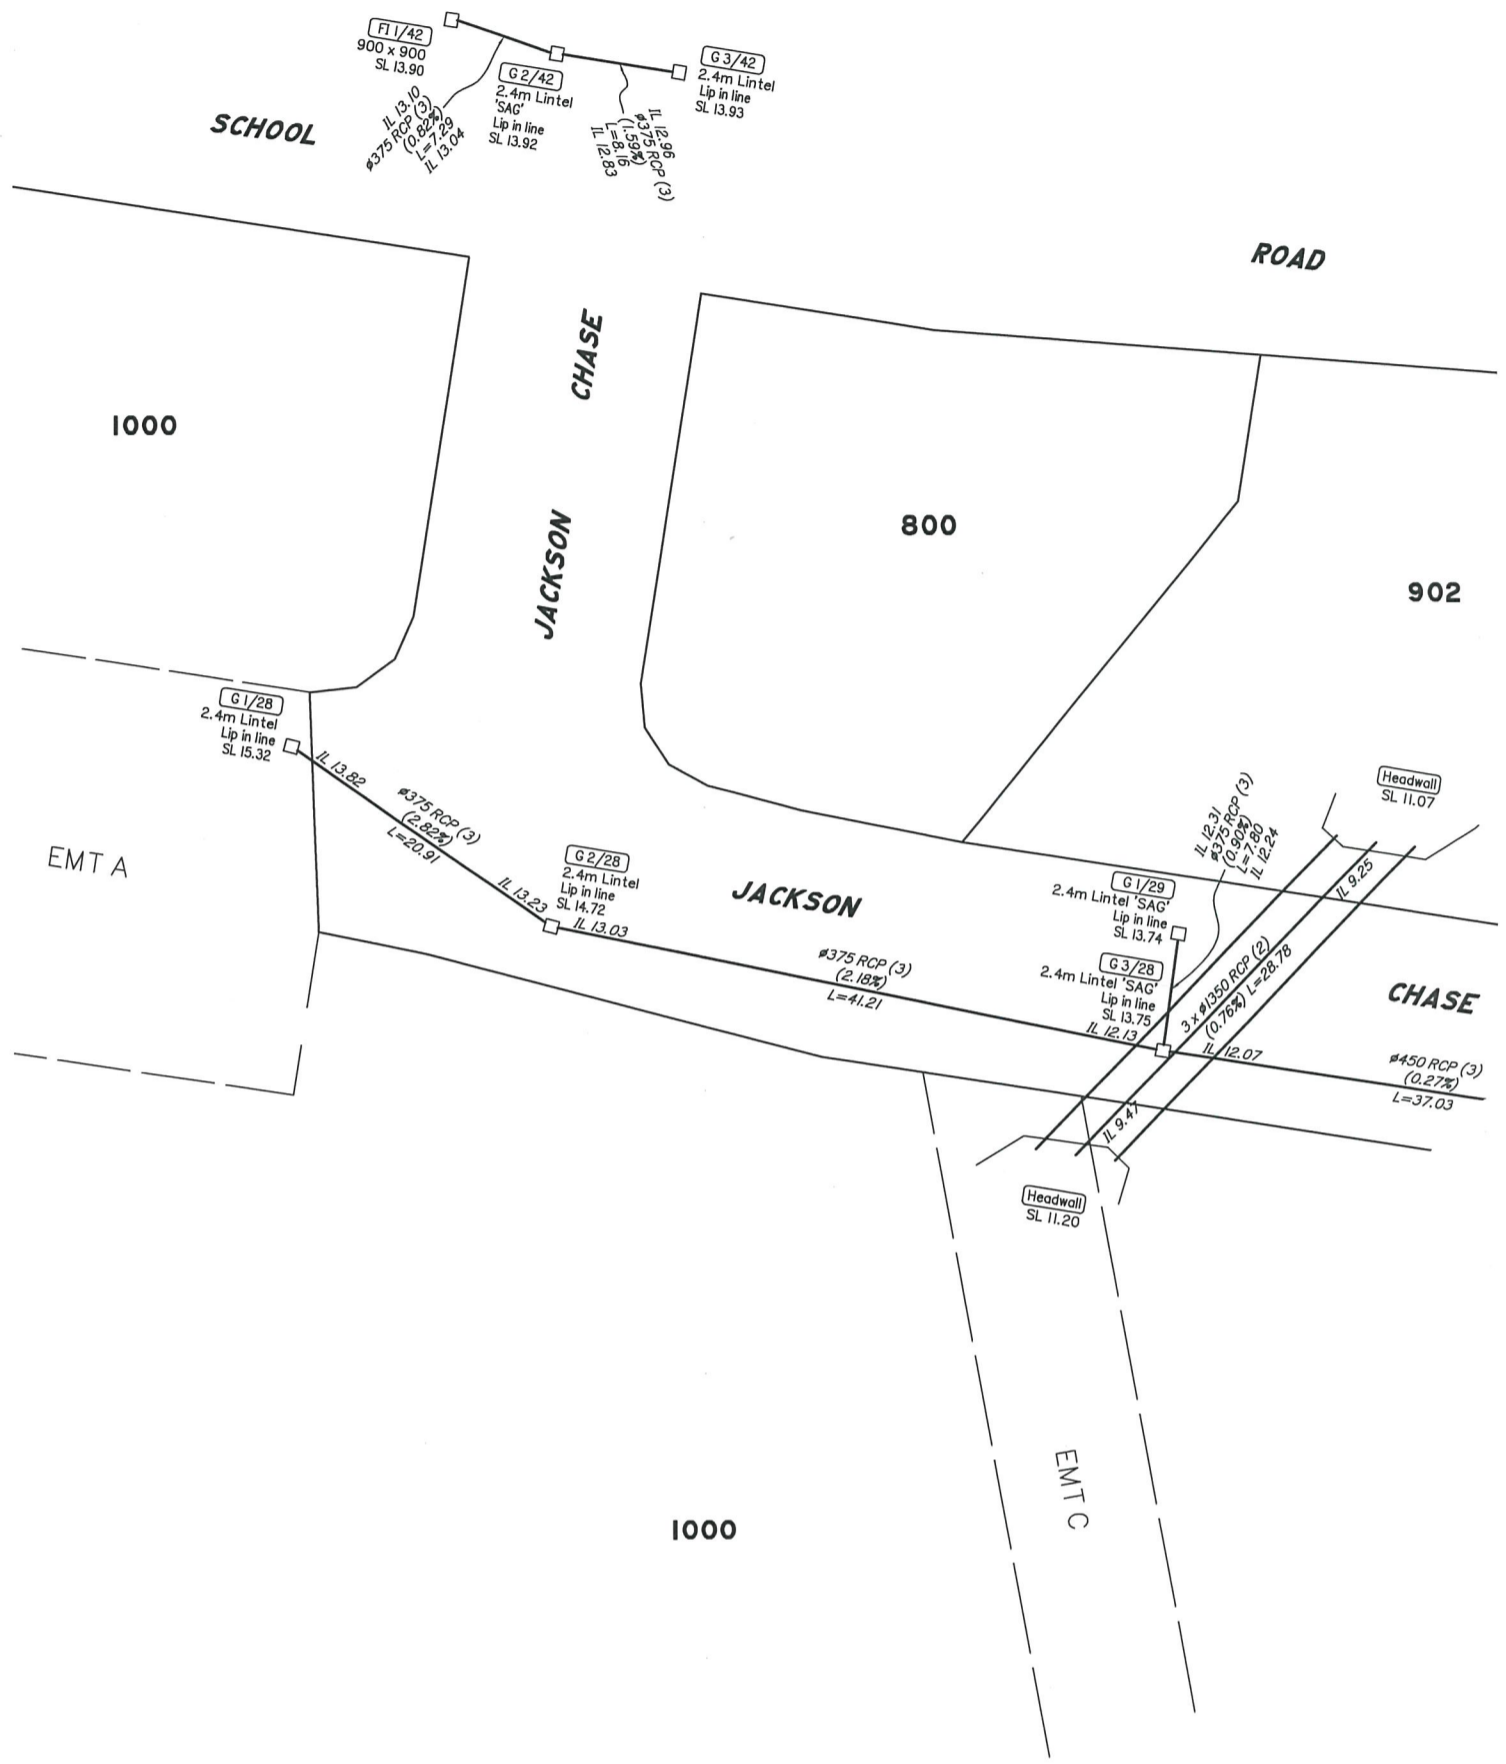

OW/24/2019
AS CONSTRUCTED REFERENCE
SET ONLY
 REFER TO SURVEYORS AS CONSTRUCTED
 PLANS FOR FINAL LEVELS AND
 CONSTRUCTED INFORMATION

ENGINEER'S CERTIFICATION - LCC REF. OW/24/2019
 I, PETER INGERMAN
 being a Consulting Engineer and duly authorised representative of -
 EMPOWER ENGINEERS AND PROJECT MANAGERS
 hereby -
 # certify the information contained in this drawing is generally in accordance with the approved design and is an accurate "as constructed" representation of the works;
 # accept responsibility for the "as constructed" information contained in this drawing; and
 # acknowledge the "as constructed" information contained in the drawing may be relied on by the LOGAN CITY COUNCIL and others.
 Certification for Stage 1 by [Signature] on 22/07/20
 For: EMPOWER ENGINEERS AND PROJECT MANAGERS RPEQ 9424

REGISTERED SURVEYOR'S CERTIFICATION
 Saunders Havill Group Pty Ltd, Registered Surveyor, hereby certify that the vertical and horizontal locations and dimensions shown on this plan are a true and correct record and were located by survey.
 [Signature]
 Authorised Signatory Reg. Surveyor No. 4611 Date: 14.07.2020

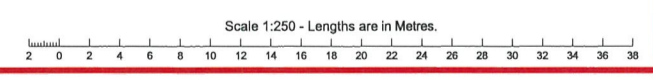

saunders havill group
 Saunders Havill Group Pty Ltd ABN 24 144 972 949
 Brisbane • Springfield • Rockhampton
 head office 9 Thompson St Bowen Hills Q 4006
 phone 1300 123 5HG web www.saundershavill.com
 # surveying # town planning # urban design # environmental management # landscape architecture


No.	Drawn	Date	Description	Checked
A	JTC	14.07.2020	Original Issue	SB

Plan of **AS CONSTRUCTED STORMWATER DRAINAGE**
 Project **THE BANKS - STAGE 1**
 Client **URBEX PTY LTD**

Surveyed BH/MB Date MAY 2020
 Level Datum: AHD der.
 Origin of Levels: PM130385
 RL of Origin: RL15.546
 Contour Interval:

Lot Description
 Plan of Lots 35, 60-63, 84-128, 194-197, 800, 901, 902, 905, 1000 & 9000 on SP313771
 Locality: Logan Reserve
 Local Government: Logan City

surveying Sheet 2 of 5
 Scale @A1 1:250
 @A3 1:500
 Dwg No. **8131 S 36 A AC**

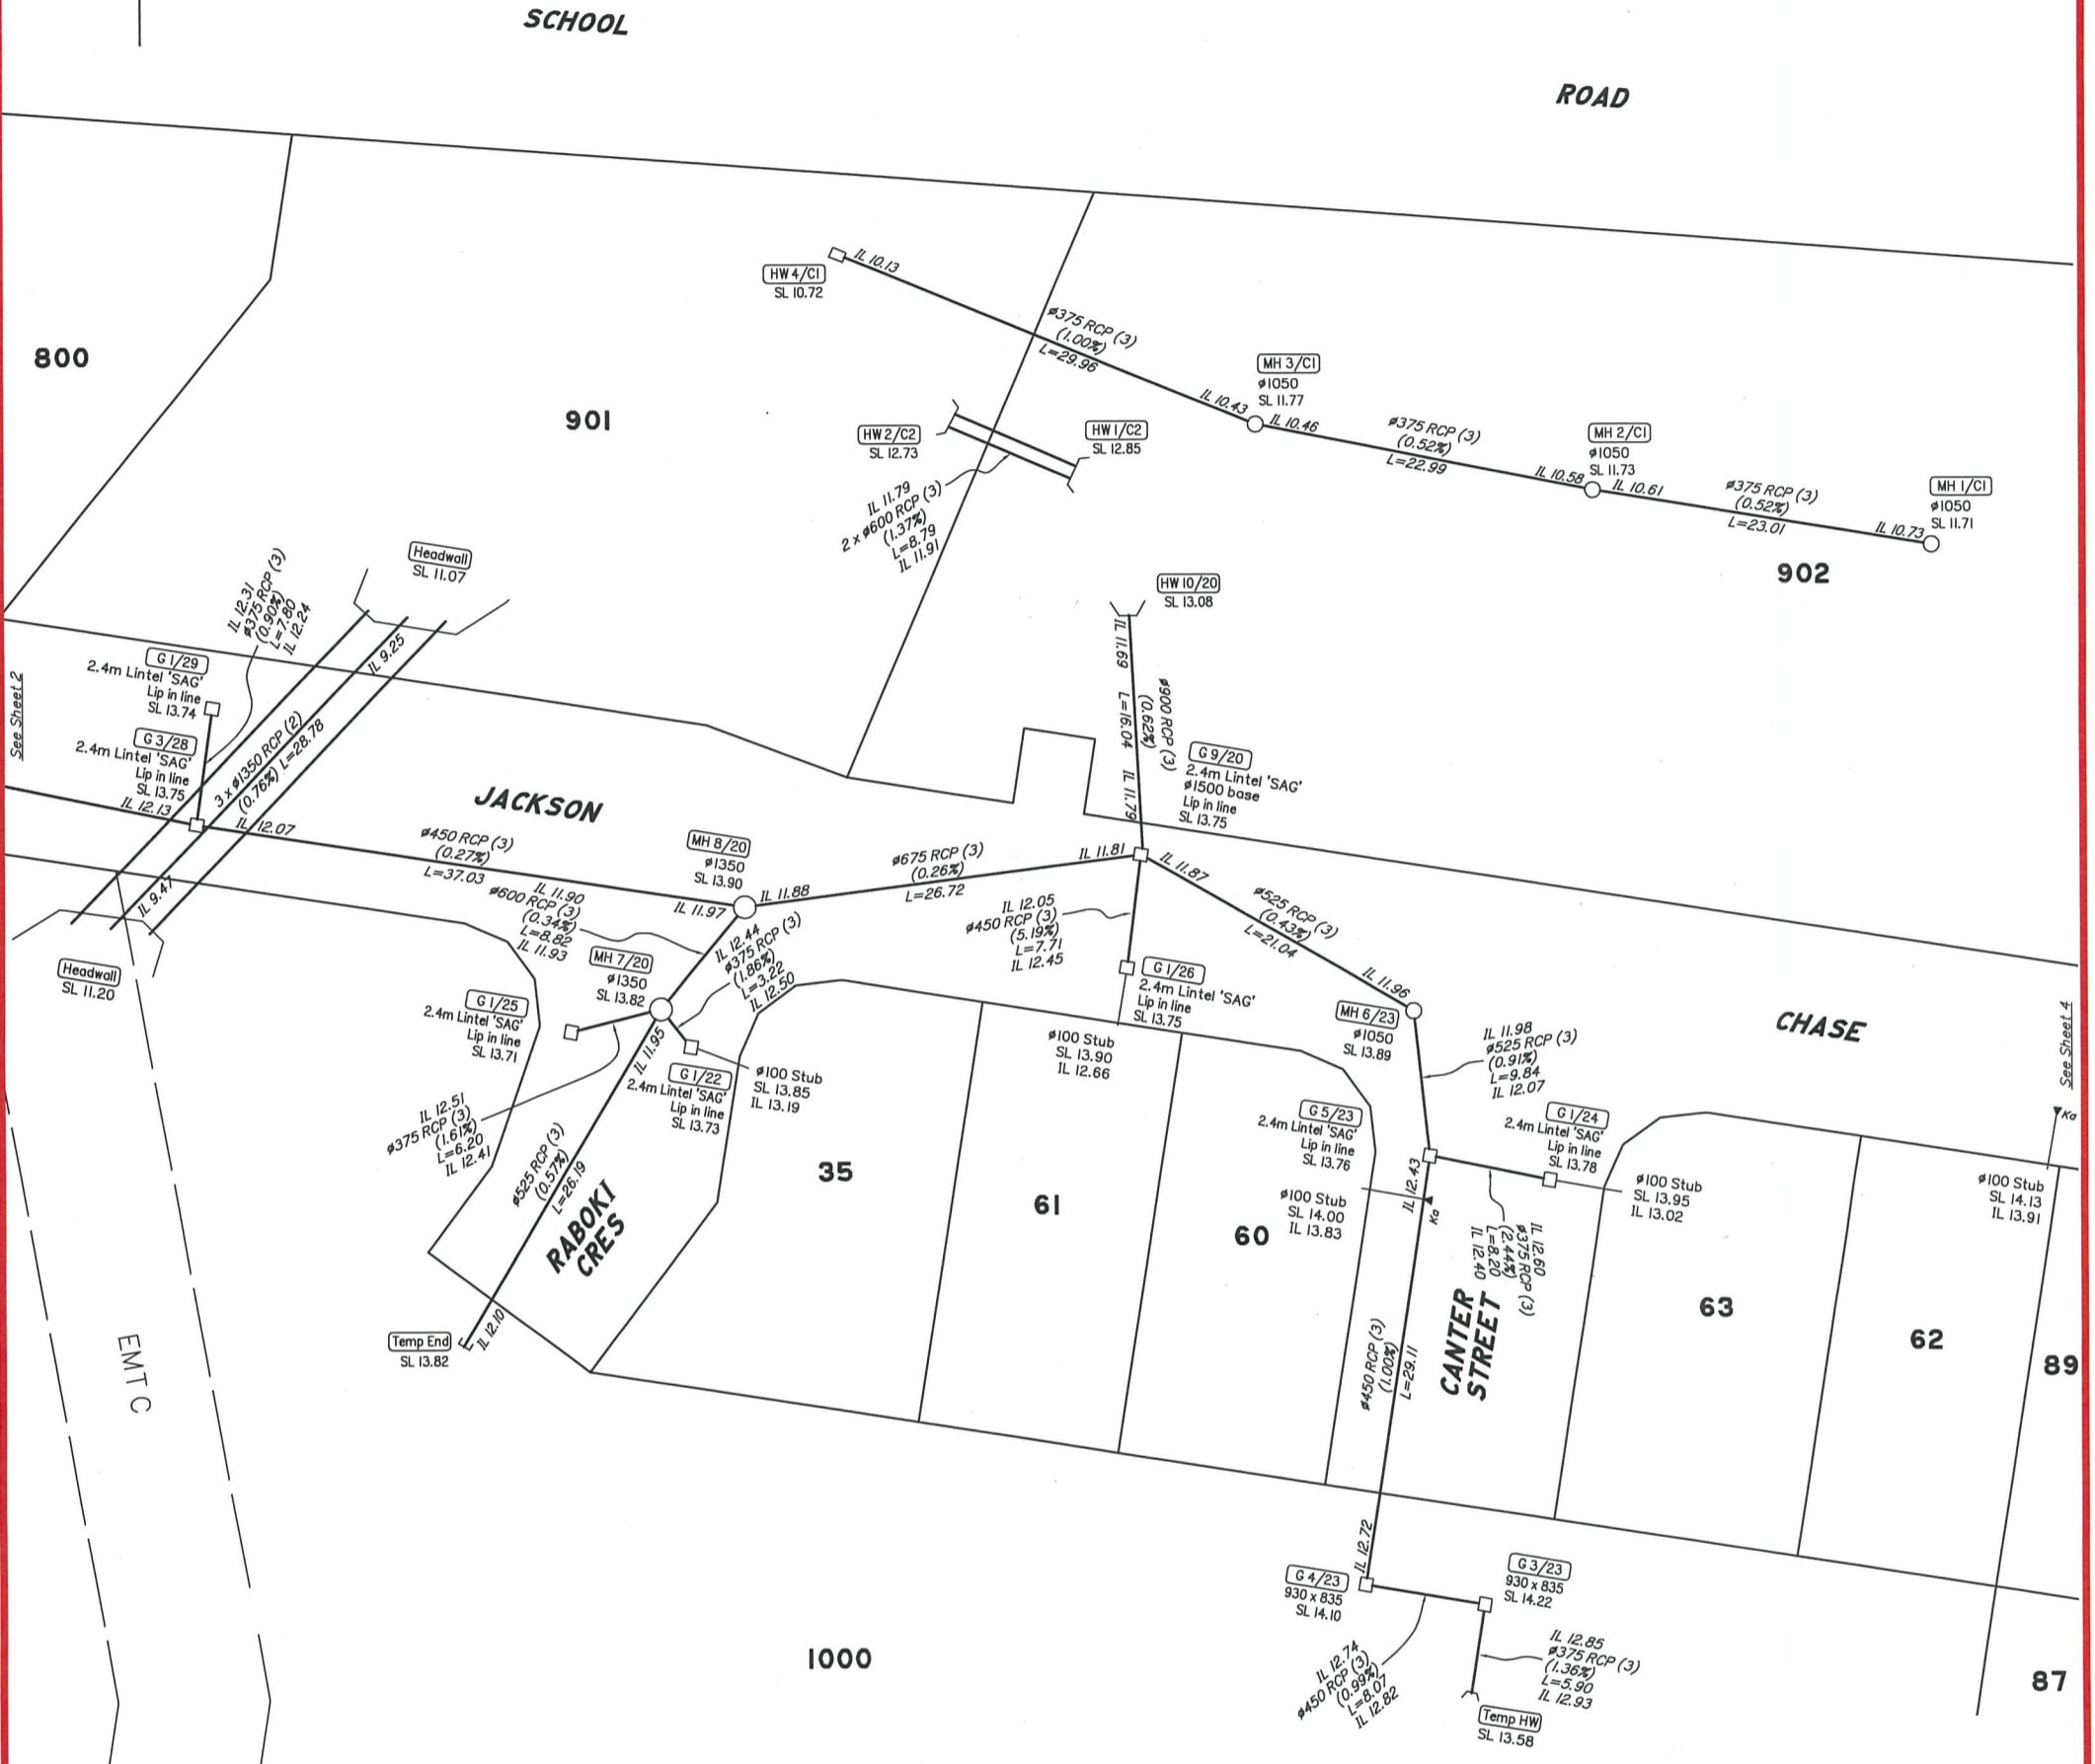

OW/24/2019
AS CONSTRUCTED REFERENCE
SET ONLY
 REFER TO SURVEYORS AS CONSTRUCTED
 PLANS FOR FINAL LEVELS AND
 CONSTRUCTED INFORMATION


ENGINEER'S CERTIFICATION - LCC REF. OW/24/2019
 I, PETER INGERMAN
 being a Consulting Engineer and duly authorised representative of -
 EMPOWER ENGINEERS AND PROJECT MANAGERS
 hereby:-
 # certify the information contained in this drawing is generally in accordance with the approved design and is an accurate "as constructed" representation of the works;
 # accept responsibility for the "as constructed" information contained in this drawing; and
 # acknowledge the "as constructed" information contained in the drawing may be relied on by the LOGAN CITY COUNCIL and others.
 Certification for Stage 1 by *[Signature]* on 22/07/20
 For: EMPOWER ENGINEERS AND PROJECT MANAGERS RPEQ.9424

REGISTERED SURVEYOR'S CERTIFICATION

Saunders Havill Group Pty Ltd, Registered Surveyor, hereby certify that the vertical and horizontal locations and dimensions shown on this plan are a true and correct record and were located by survey.

[Signature]
 Authorised Signatory Reg. Surveyor No. 4611 Date: 14.07.2020

 Scale 1:250 - Lengths are in Metres.



Saunders Havill Group Pty Ltd ABN 24 144 972 949
 Brisbane • Springfield • Rockhampton
 head office 9 Thompson St Bowen Hills Q 4006
 phone 1300 123 SHG web www.saundershavill.com

• surveying • town planning • urban design • environmental management • landscape architecture


No.	Drawn	Date	Description	Checked
A	JTC	14.07.2020	Original Issue	SB

Plan of **AS CONSTRUCTED STORMWATER DRAINAGE**
 Project **THE BANKS - STAGE 1**
 Client **URBEX PTY LTD**

Surveyed BH/MB Date MAY 2020
 Level Datum: AHD der.
 Origin of Levels: PM130385
 RL of Origin: RL15.546
 Contour Interval:

Lot Description
 Plan of Lots 35, 60-63, 84-128, 194-197, 800, 901, 902, 905, 1000 & 9000 on SP313771
 Locality: Logan Reserve
 Local Government: Logan City

Sheet 3 of 5
 Scale @A1 1:250
 @A3 1:500
 Dwg No. 8131 S 36 A AC

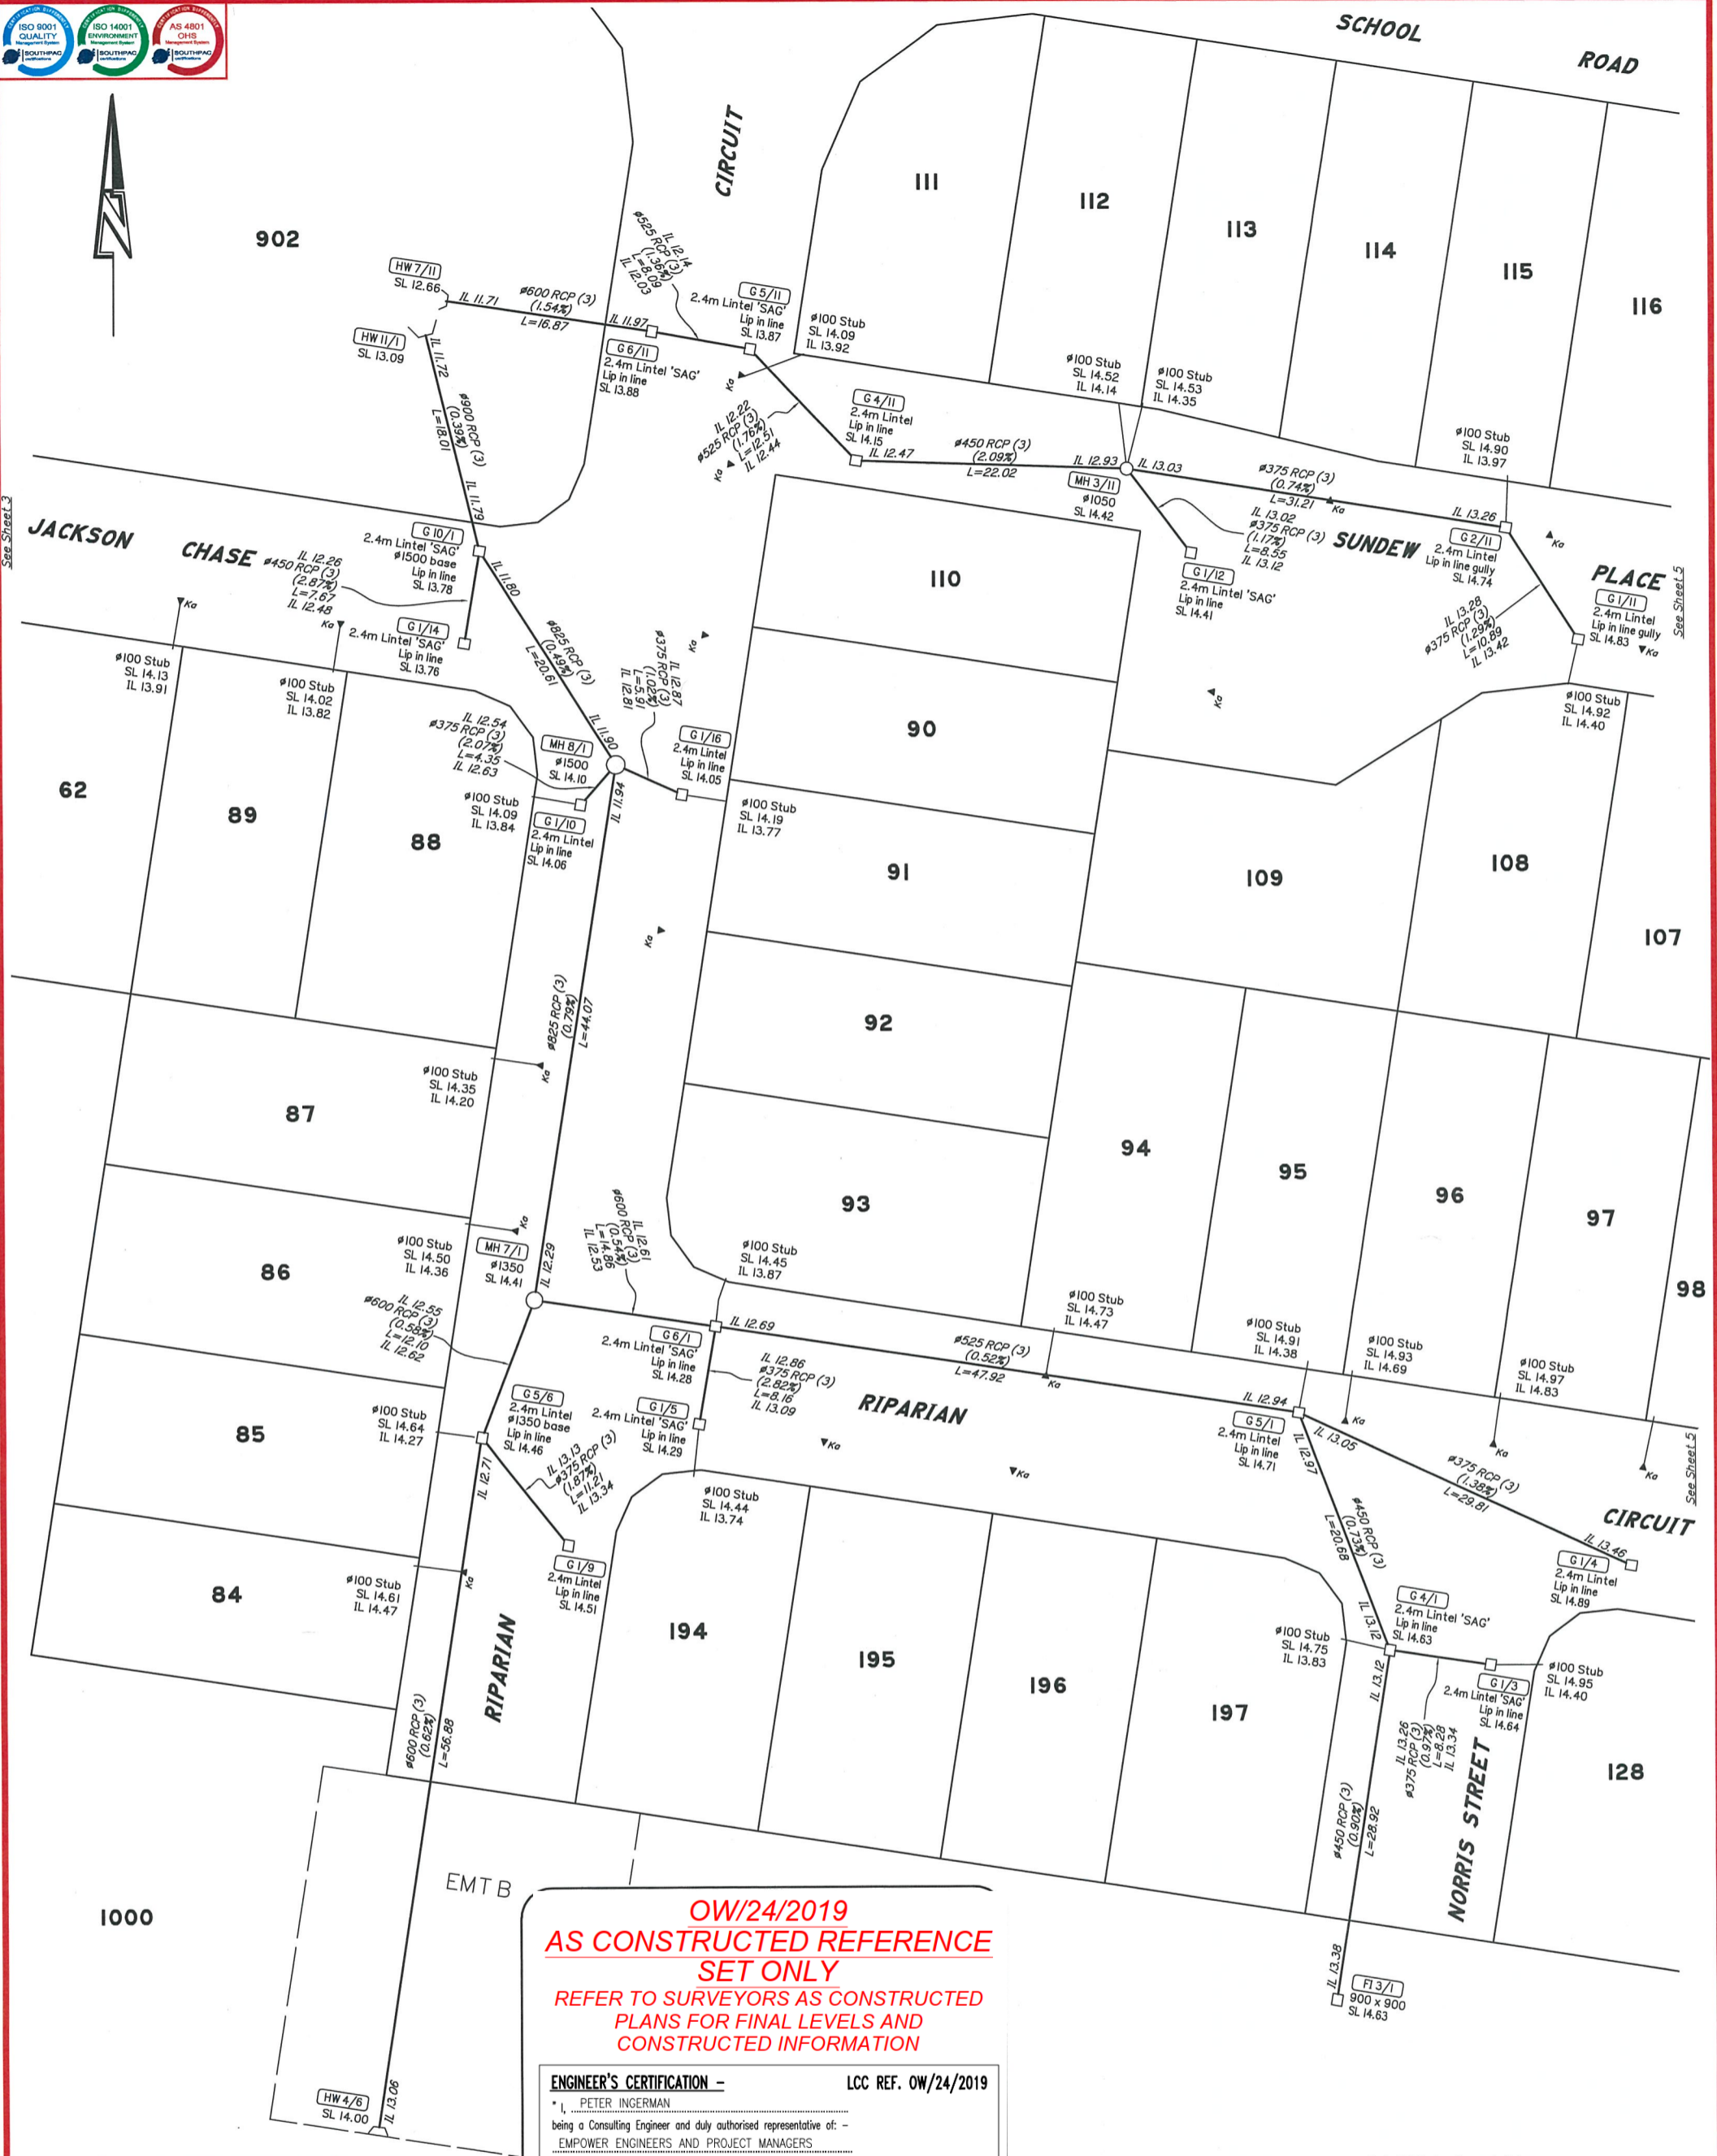

**OW/24/2019
AS CONSTRUCTED REFERENCE
SET ONLY**

REFER TO SURVEYORS AS CONSTRUCTED
PLANS FOR FINAL LEVELS AND
CONSTRUCTED INFORMATION


ENGINEER'S CERTIFICATION - LCC REF. OW/24/2019

I, PETER INGERMAN
being a Consulting Engineer and duly authorised representative of -
EMPOWER ENGINEERS AND PROJECT MANAGERS
hereby:-
certify the information contained in this drawing is generally in accordance with the approved design and is an accurate "as constructed" representation of the works;
accept responsibility for the "as constructed" information contained in this drawing; and
acknowledge the "as constructed" information contained in the drawing may be relied on by the LOGAN CITY COUNCIL and others.
Certification for Stage 1 by K on 22/07/20
For: EMPOWER ENGINEERS AND PROJECT MANAGERS RPEQ 9424

REGISTERED SURVEYOR'S CERTIFICATION

Saunders Havill Group Pty Ltd, Registered Surveyor, hereby certify that the vertical and horizontal locations and dimensions shown on this plan are a true and correct record and were located by survey.

[Signature]
Authorised Signatory Reg. Surveyor No. 4611 Date: 14.07.2020

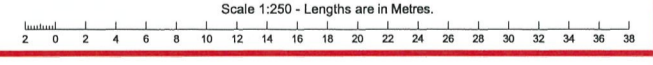

saunders havill group Saunders Havill Group Pty Ltd ABN 24 144 972 949
Brisbane • Springfield • Rockhampton
head office 9 Thompson St Bowen Hills Q 4006
phone 1300 123 SHG web www.saundershavill.com

• surveying • town planning • urban design • environmental management • landscape architecture

No.	Drawn	Date	Description	Checked
A	JTC	14.07.2020	Original Issue	SB

**AS CONSTRUCTED
STORMWATER DRAINAGE**

Project: **THE BANKS - STAGE 1**

Client: **URBEX PTY LTD**

Surveyed: BH/MB Date: MAY 2020
Level Datum: AHD der.
Origin of Levels: PM130385
RL of Origin: RL15.546
Contour Interval:


Lot Description
Plan of Lots 35, 60-63, 84-128, 194-197, 800, 901, 902, 905, 1000 & 9000 on SP313771
Locality: Logan Reserve
Local Government: Logan City

Sheet 4 of 5
Scale @A1 1: 250
@A3 1: 500
Dwg No. 8131 S 36 A AC



OW/24/2019
AS CONSTRUCTED REFERENCE SET ONLY
 REFER TO SURVEYORS AS CONSTRUCTED PLANS FOR FINAL LEVELS AND CONSTRUCTED INFORMATION

ENGINEER'S CERTIFICATION - LCC REF. OW/24/2019
 * I, PETER INGERMAN
 being a Consulting Engineer and duly authorised representative of: -
 EMPOWER ENGINEERS AND PROJECT MANAGERS
 hereby:-
 # certify the information contained in this drawing is generally in accordance with the approved design and is an accurate "as constructed" representation of the works;
 # accept responsibility for the "as constructed" information contained in this drawing; and
 # acknowledge the "as constructed" information contained in the drawing may be relied on by the LOGAN CITY COUNCIL and others.
 Certification for Stage 1 by K on 22/07/20
 For: EMPOWER ENGINEERS AND PROJECT MANAGERS RPEQ.9424

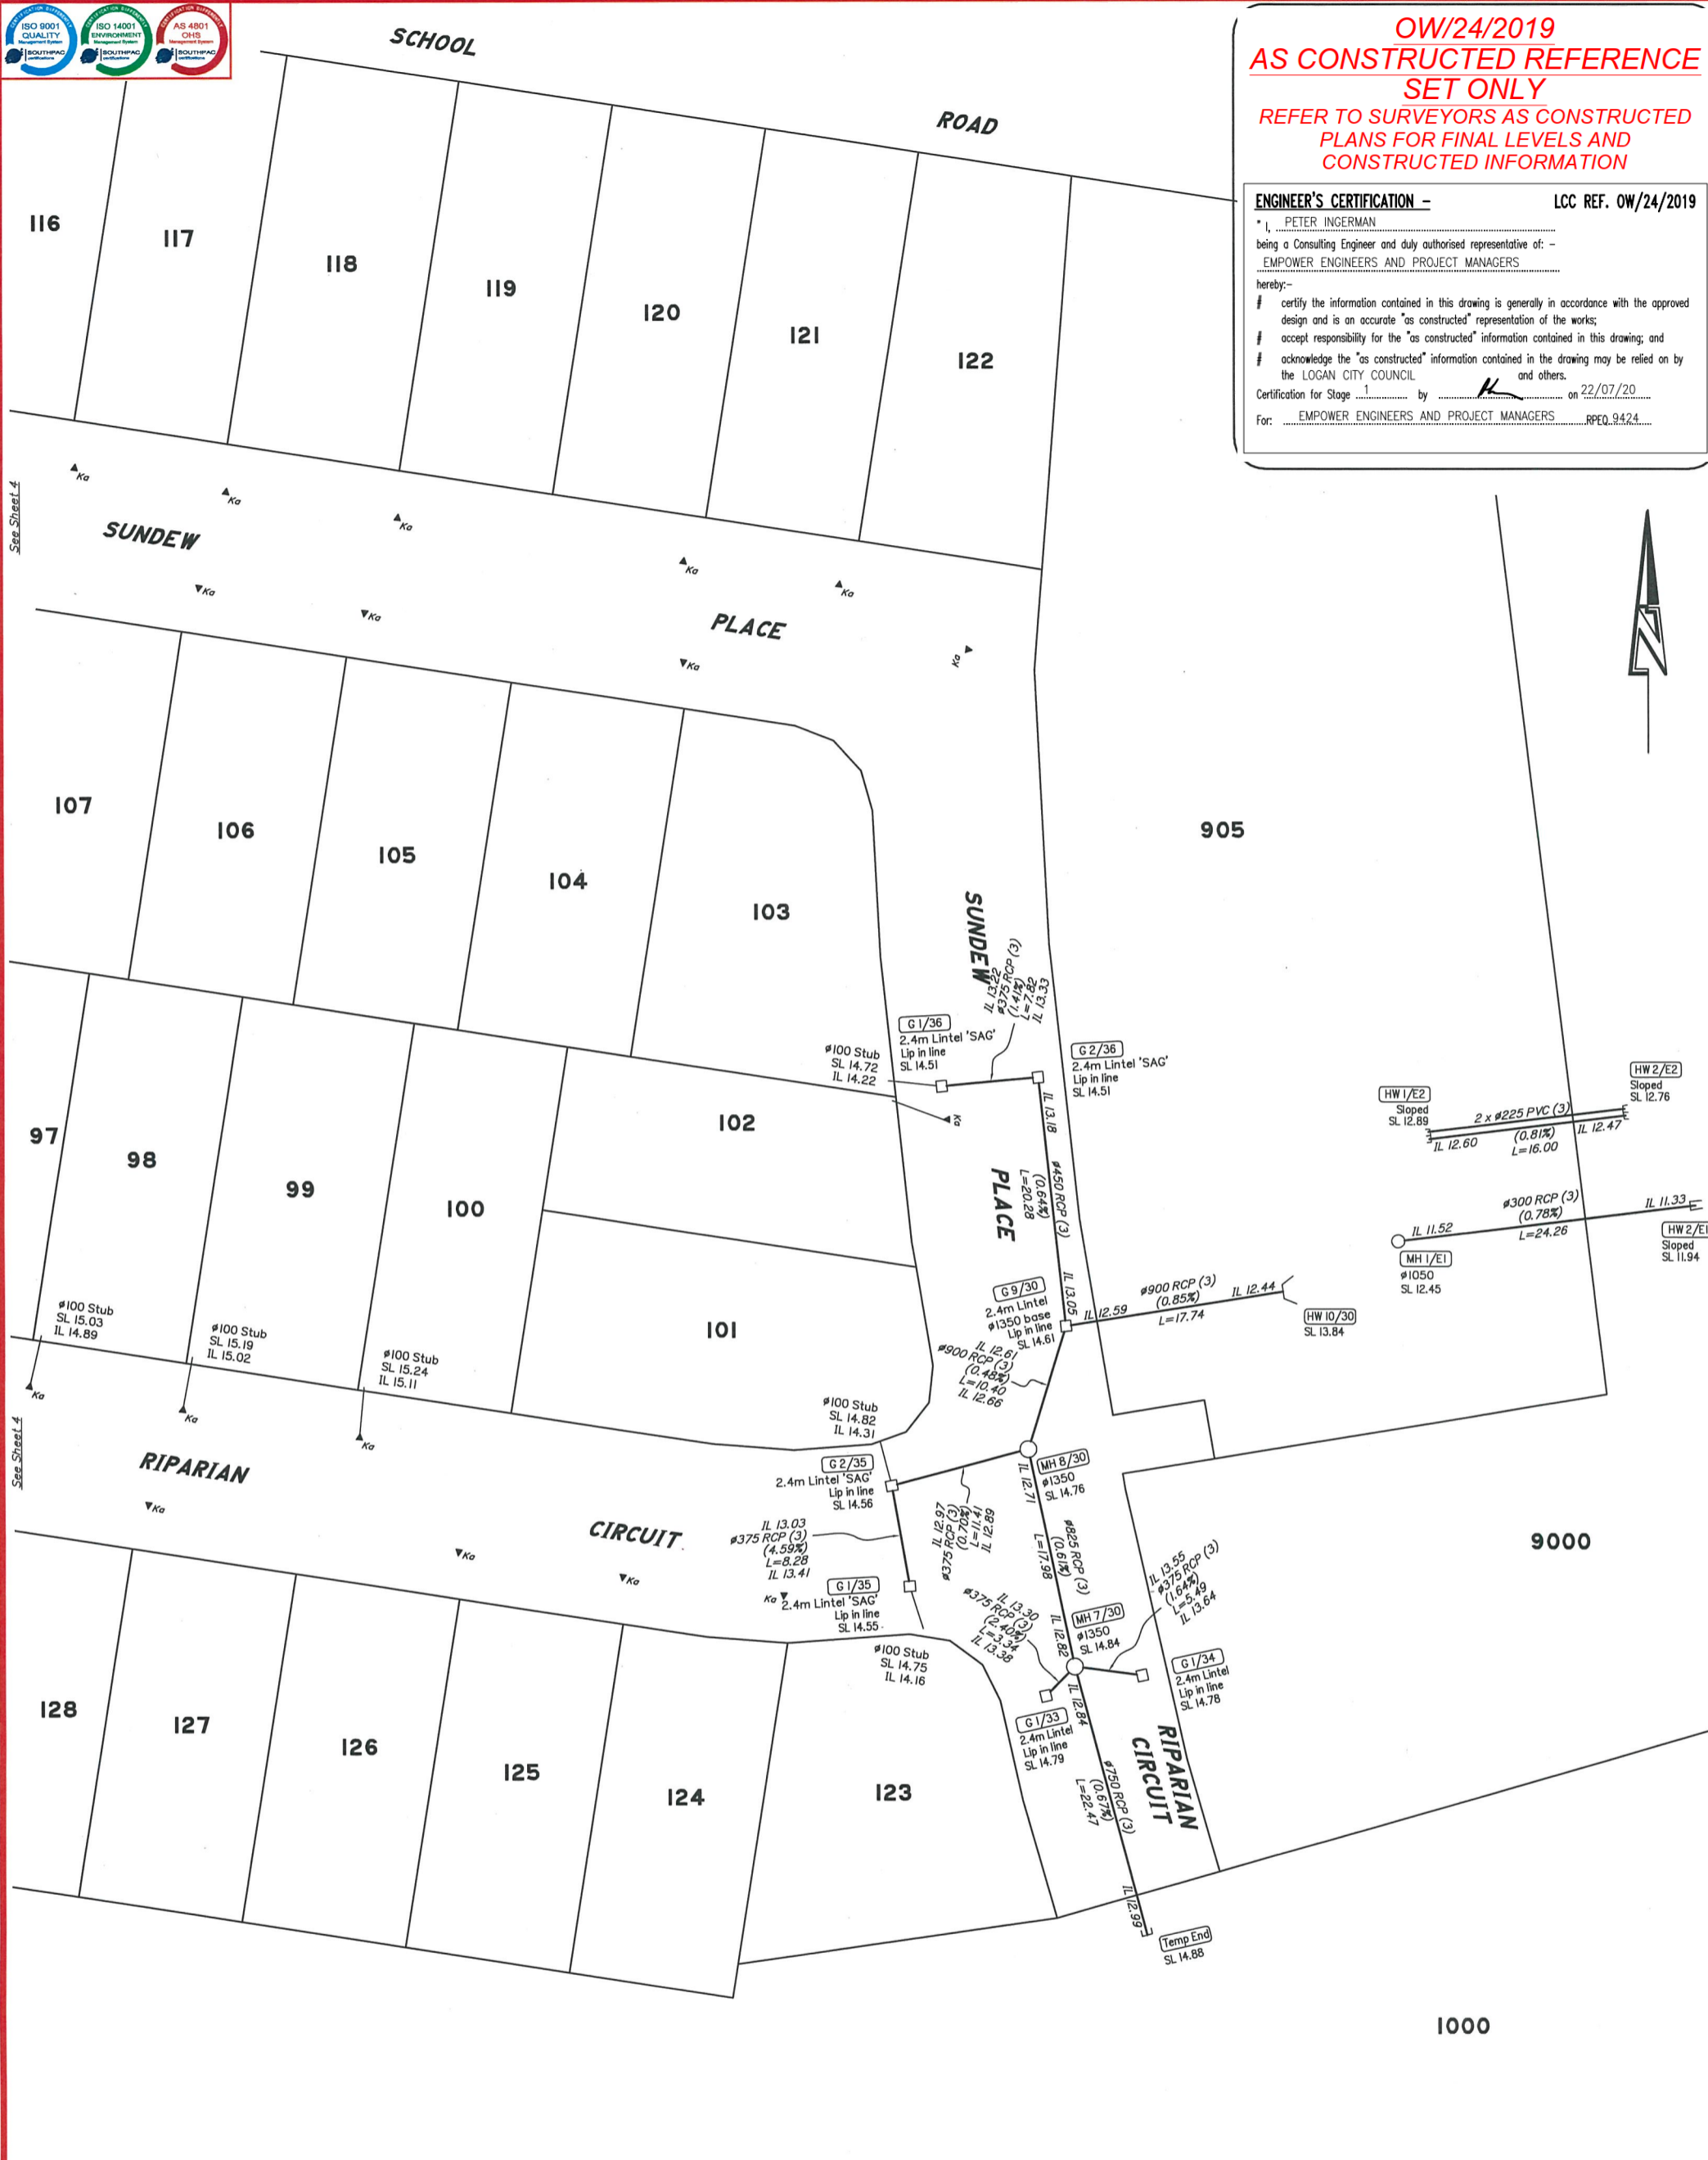

REGISTERED SURVEYOR'S CERTIFICATION
 Saunders Havill Group Pty Ltd, Registered Surveyor, hereby certify that the vertical and horizontal locations and dimensions shown on this plan are a true and correct record and were located by survey.

 Authorised Signatory Reg. Surveyor No. 4611 Date: 14.07.2020

Scale 1:250 - Lengths are in Metres.
 2 0 2 4 6 8 10 12 14 16 18 20 22 24 26 28 30 32 34 36 38

saunders havill group
 Saunders Havill Group Pty Ltd ABN 24 144 972 949
 Brisbane • Springfield • Rockhampton
 head office 9 Thompson St Bowen Hills Q 4006
 phone 1300 123 SHG web www.saundershavill.com
 # surveying # town planning # urban design # environmental management # landscape architecture

No.	Drawn	Date	Description	Checked
A	JTC	14.07.2020	Original Issue	SB

AS CONSTRUCTED STORMWATER DRAINAGE

Project: **THE BANKS - STAGE 1**

Client: **URBEX PTY LTD**

Surveyed	Date
BH/MB	MAY 2020

Level Datum: AHD der.
 Origin of Levels: PM130385
 RL of Origin: RL15.546
 Contour Interval:

Lot Description
 Plan of Lots 35, 60-63, 84-128, 194-197, 800, 901, 902, 905, 1000 & 9000 on SP313771
 Locality: Logan Reserve
 Local Government: Logan City

Sheet 5 of 5
 Scale @A1 1:250
 @A3 1:500
 Dwg No. 8131 S 36 A AC